**Lighting Schedule**

| Item # | Qty. | Description | Manufacturer | Model | Mounting | Lamp Type | Lamp Qty. | Remarks |
|---|---|---|---|---|---|---|---|---|
| | | | | | | | | |
| | | | | | | | | |
| R1 | 15 | RECESSED CAN | LITHONIA | 4BP MW LED 30K90CR1 | GYP. CEILING | LED | 1 | |
| LED-1 | 22 | ENLCOSED LED | LITHONIA | DMW-2-32-MVOLT-GEB10IS-WLF | CEILING | | | BREWERY, WET LOCATION |
| LED-2 | 46 | 2x4 LED | LITHONIA | IBH-9000LM-SD080-MD | CEILING | | | MATTE BLACK FINISH |
| C1 | 4 | FUTURE | FUTURE | FUTURE | FUTURE | | | FUTURE |
| EM1 | TBD | EMERGENCY LIGHT | DUAL LITE | LZ SERIES | WALL | | | |
| X1 | TBD | EXIT LIGHTING | DUAL LITE | HCX SERIES | WALL OR CEILING | | | W/ BATTERY BACKUP |

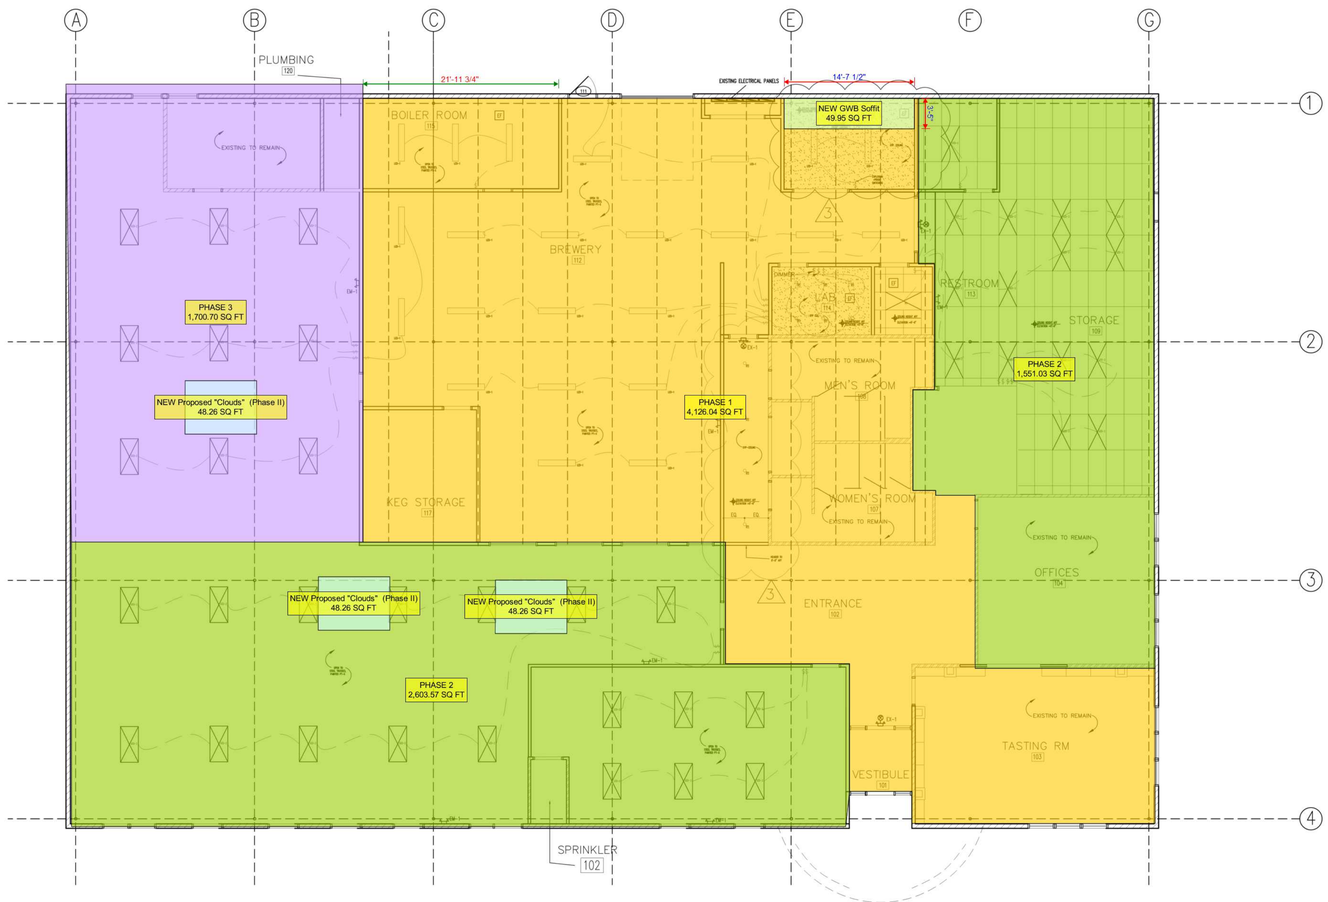


| | |
|---|---|
| NEW GWB Soffit | 50.0 SQ FT |
| NEW Proposed "Clouds" (Phase II) | 144.8 SQ FT |
| PHASE 1 | 4,126.0 SQ FT |
| PHASE 2 | 4,154.6 SQ FT |
| PHASE 3 | 1,700.7 SQ FT |

REFLECTED CEILING PLAN

1/4"=1'-0" | 3


SPACES DESIGN STUDIO, LLC.
417 William Street
Fredericksburg, VA 22401
www.fredericksburgspaces.com
540.371.3674


SYMBOLS:

- 3A — WALL TYPE
- 101 — ROOM NUMBER
- 1 — EQUIPMENT NUMBER
- 1 — WINDOW NUMBER
- 102 — DOOR NUMBER
- $ — LIGHT SWITCH
- LED-2 — 2 X 4 LED
- R1 — 4" LED RECESSED CAN
- LED-1 — ENCLOSED LED
- EXISTING CONSTRUCTION
- EF — EXHAUST FAN
- EXIT LIGHT W/ BATTERY BACKUP
- WALL MOUNTED EXIT LIGHTING

GENERAL NOTES:

1. INTERIOR WALL PARTITIONS ARE 3-5/8" METAL STUD UNLESS OTHERWISE NOTED.
2. CONTRACTOR TO VERIFY ALL EXISTING DIMENSIONS AND CONDITIONS.
3. REFER TO A4.0 FOR PLAN DETAILS, WALL TYPES AND INTERIOR ELEVATIONS.
4. REFER TO MEP DRAWINGS FOR ALL ELECTRICAL & MECHANICAL DETAILS.
5. MEP TO DETERMINE FINAL QUANTITY & LOCATION OF EXIT / EGRESS LIGHTING
6. REFER TO MEP DRAWNGS FOR LIGHTING & ELECTRICAL DETAILS.

ADDENDA / REVISIONS

| DATE | USE | INITIALS |
|---|---|---|
| 2015.07.21 | REVIEW | MTC |
| 2016.06.16 | PERMIT | KMP |
| 2016.08.01 | REVISION 3 | KMP |

Project:
6 Bears and a Goat Brewery
Stafford, VA

Sheet:
Reflected Ceiling Plan Key
Reflected Ceiling Plans

Issue:
~~PERMIT~~

Date:
~~2015.07.21~~

Sheet No:
A1.7